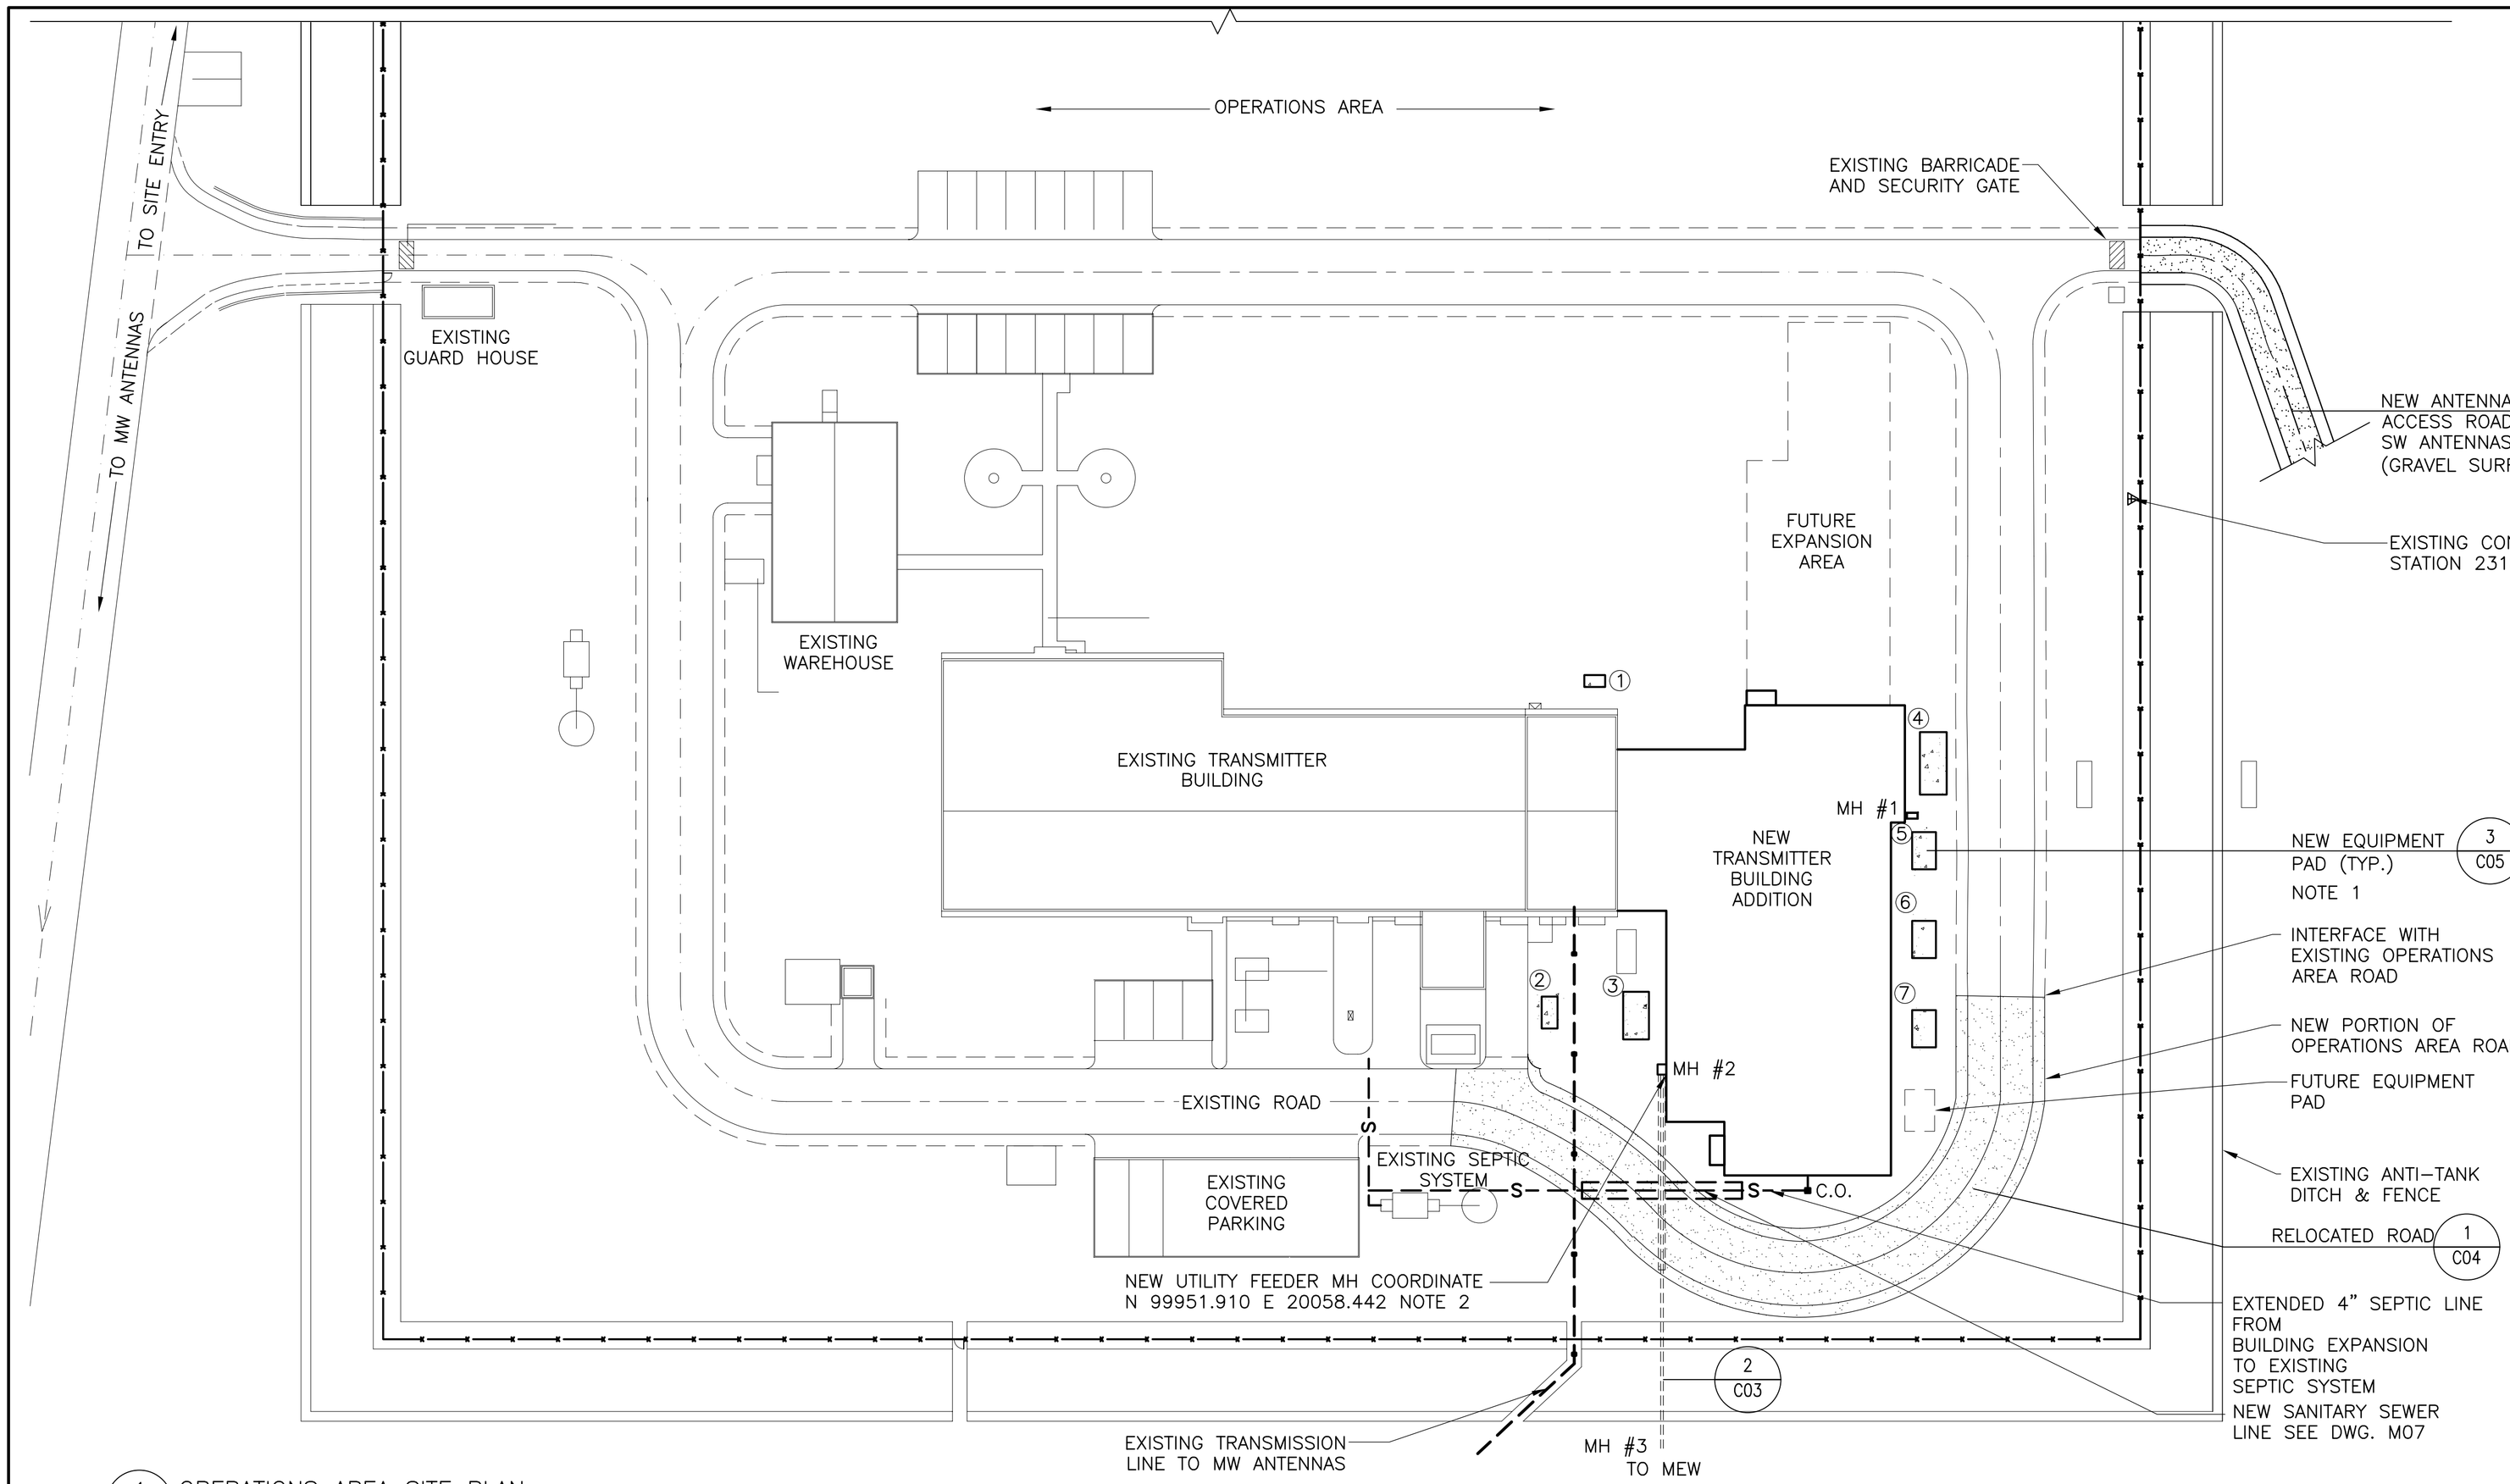

1 C03 OPERATIONS AREA SITE PLAN
1:400

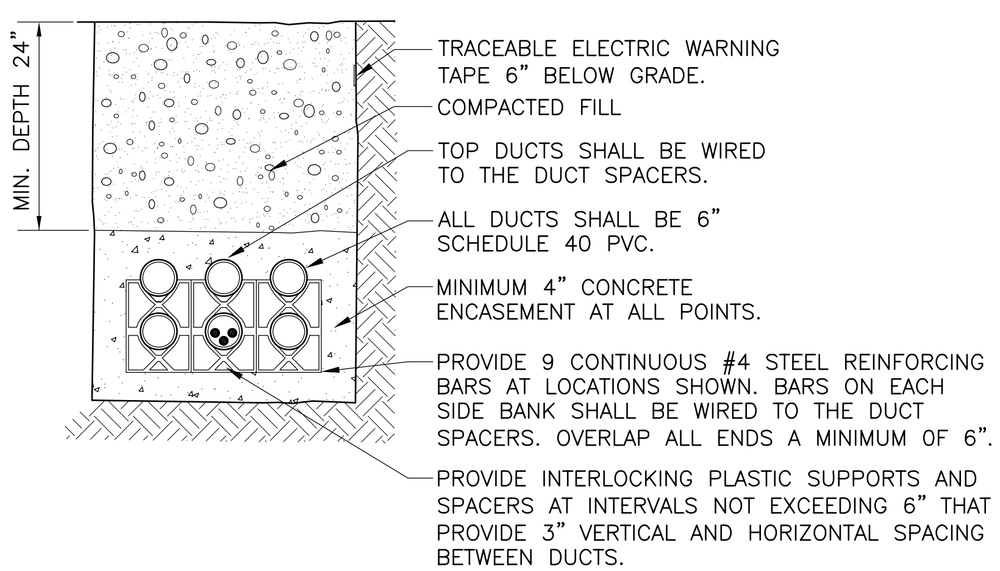

2 C03 6" ELECTRICAL DUCT BANK DETAIL
N.T.S.

LEGEND

- EXISTING COMMUNICATIONS ANTENNAS TO REMAIN
- ① CONCRETE EQUIPMENT PAD
- CHAIN LINK SECURITY FENCE
- BURIED UTILITY SERVICE IN PIPE SLEEVE UNDER ROAD CROSSINGS
- —S— SANITARY SEWER PIPE
- —CO— CLEAN OUT
- CONCRETE MANHOLE PER MEW SPECIFICATIONS

AS BUILT

GRAPHIC SCALE:
0 5m 10m 20m
SCALE: 1:400 (METRIC)

SEAL:

REV	DESCRIPTIONS	DATE	APPD.

REVISION

INTERNATIONAL BROADCASTING BUREAU
ENGINEERING & TECHNICAL OPERATIONS
WASHINGTON, D.C. 20547

Bader Al Mulla & Bros. Co. W.L.L.
Engineering Group

		DATE
DRAWN	HAK	23/05/04
CHK. BY.	JPB	DATE
ENGR.	JPB	DATE

APPROVALS
PROJ. MANAGER TC

SHORTWAVE EXPANSION PROJECT
OPERATIONS AREA
SITE PLAN
KUWAIT

IQC No. XX-XX-XX
TASK No. X
PROJ. No. 03NC080
CAD DESIGN FILE NAME: FILENAME

DWG. No. BMB-AS-C-03 C03
SCALE: AS SHOWN SHEET 1 OF SHT

30 Galesi Drive, Wayne, N.J. 07470
TEL : (973) 785-4646
FAX : (973) 785-0786
www.hansonengineers.com
HANSON
THALES BROADCAST & MULTIMEDIA
676 North Washington St., Alexandria, VA. 22314
TEL : (703) 836-5244
FAX : (703) 836-5264
www.thales-bcs.com