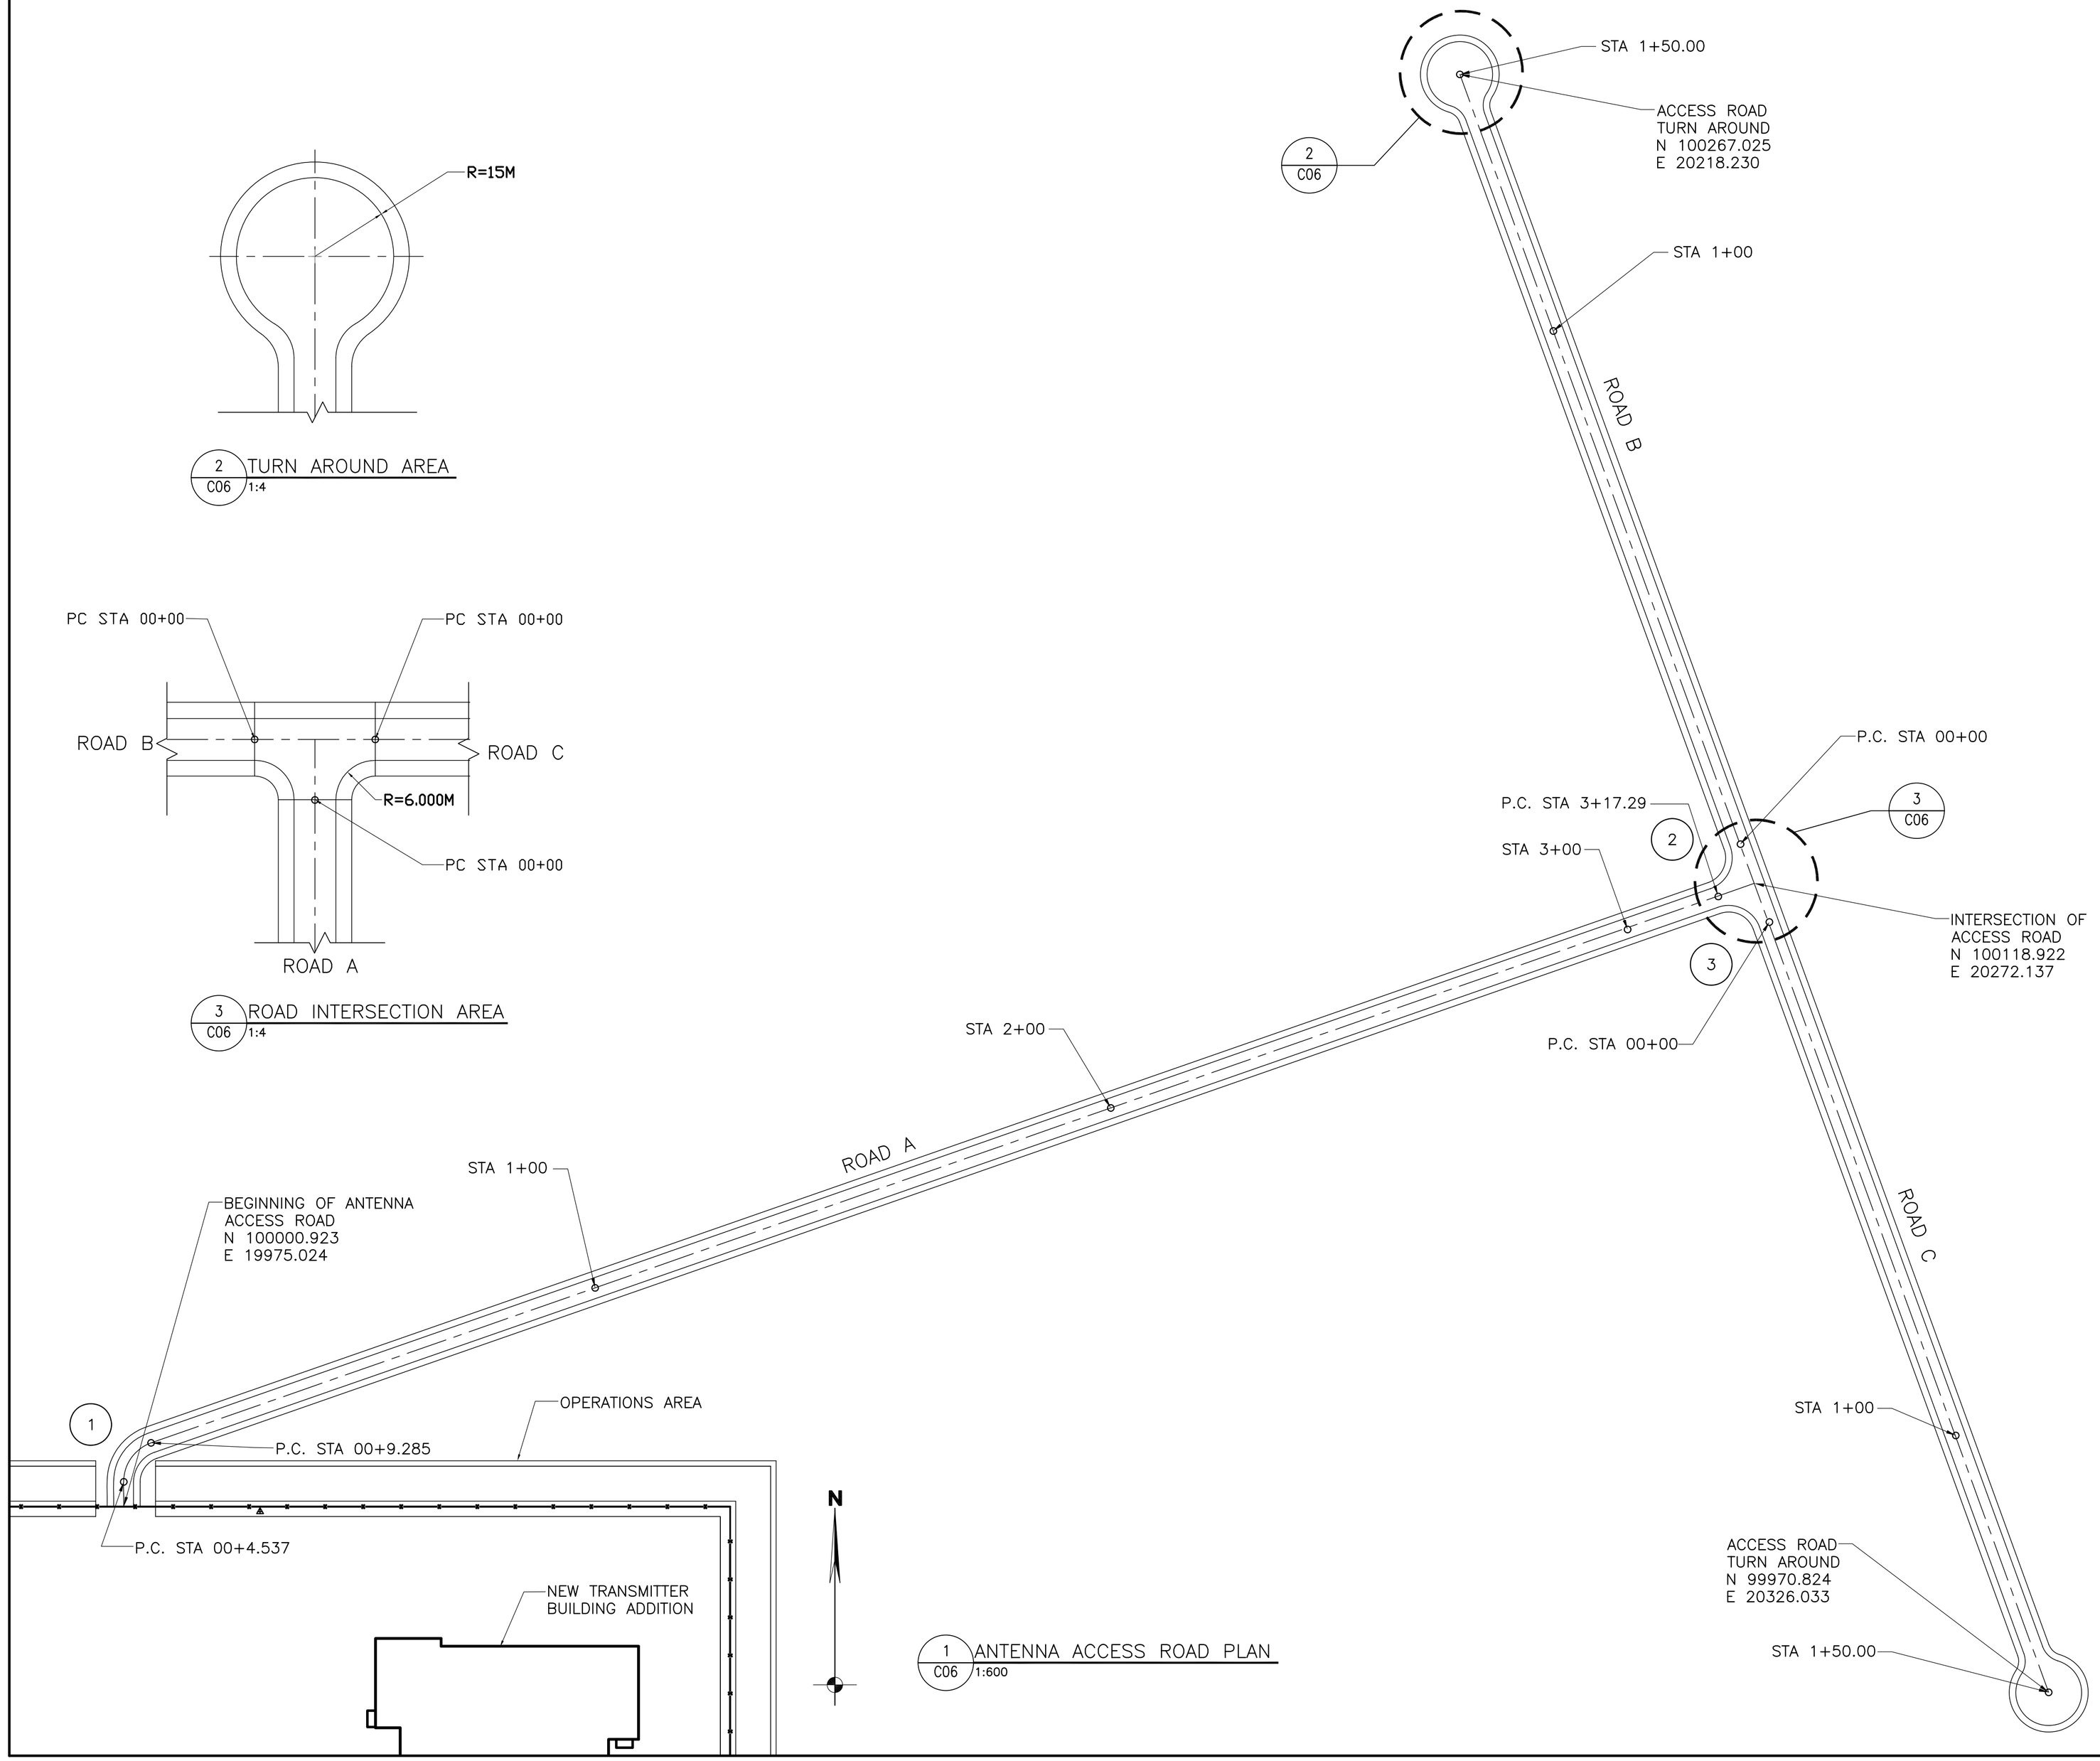

NOTES

1. ALL DIMENSIONS ARE IN METERS UNLESS OTHERWISE NOTED.
2. ALL ANGLES ARE IN DEGREES, MINUTES, & SECONDS (00° 00' 00").

LEGEND

(1) CURVE NUMBER

P.C. = POINT OF CURVATURE

STA 1+00 = STATION POINT

CURVE	△	RADIUS	LENGTH
1	90°	8.0	9.285
2	90°	6.0	9.426
3	90°	6.0	9.426

AS BUILT

GRAPHIC SCALE:

0 10m 20m 40m
SCALE: 1:600 (METRIC)

0 7.5m 15m 30m
SCALE: 1:4 (METRIC)

SEAL:

REV	DESCRIPTIONS	DATE	APPD.

REVISION

INTERNATIONAL BROADCASTING BUREAU
ENGINEERING & TECHNICAL OPERATIONS
WASHINGTON, D.C. 20547

Bader Al Mulla & Bros. Co. W.L.L.
Engineering Group

		DATE
DRAWN	HAK	23/05/04
CHK. BY.	JPB	DATE
ENGR.	JPB	DATE

APPROVALS
PROJ. MANAGER TC

SHORTWAVE EXPANSION PROJECT
ACCESS ROAD
PLAN & DETAILS
KUWAIT

IQC No. XX-XX-XX
TASK No. X
PROJ. No. 03NC080
CAD DESIGN FILE NAME: FILENAME

DWG. No. BMB-AS-C-06 C06
SCALE: AS SHOWN SHEET 1 OF SHT

HANSON THALES