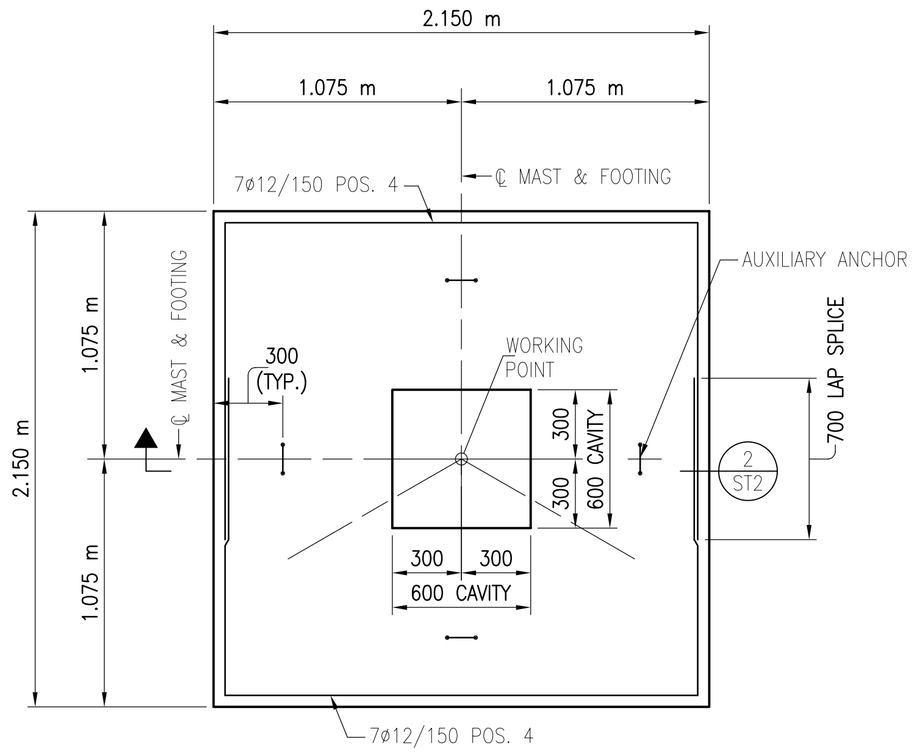

1 ST2 PLAN – TYPE A 1:20

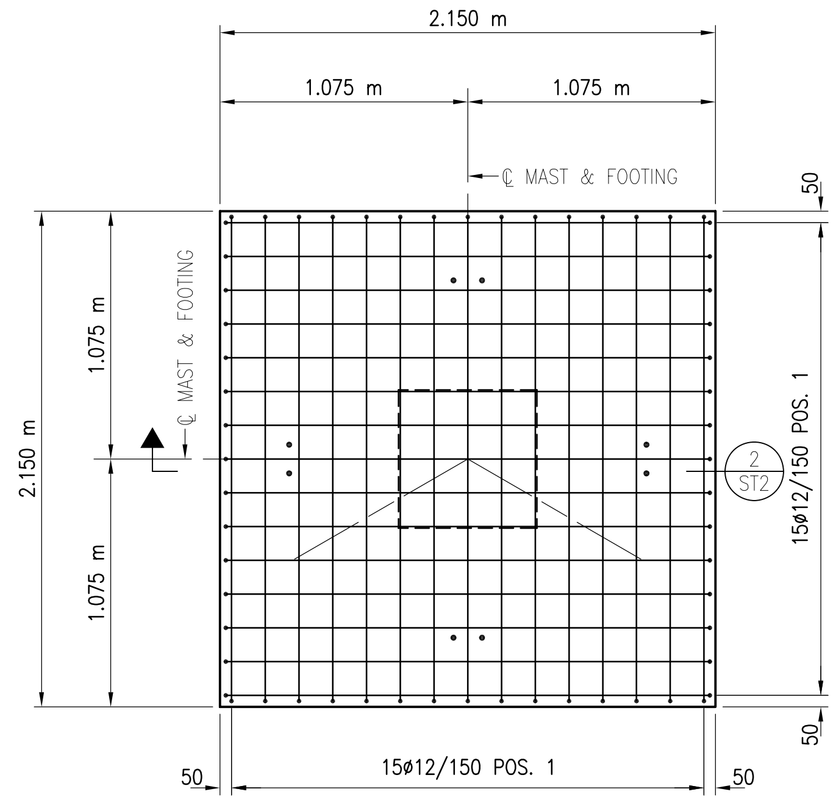

3 ST2 PLAN – LOWER REINFORCEMENT 1:20

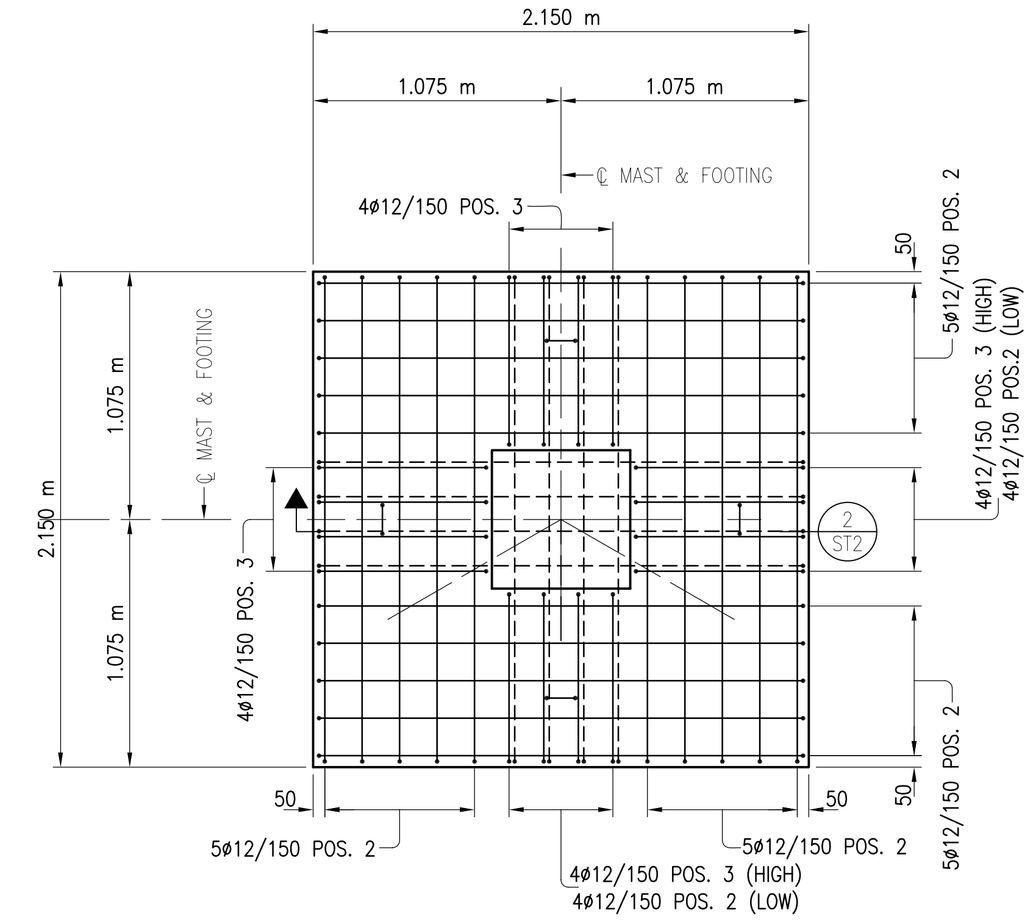

4 ST2 PLAN – UPPER REINFORCEMENT 1:20

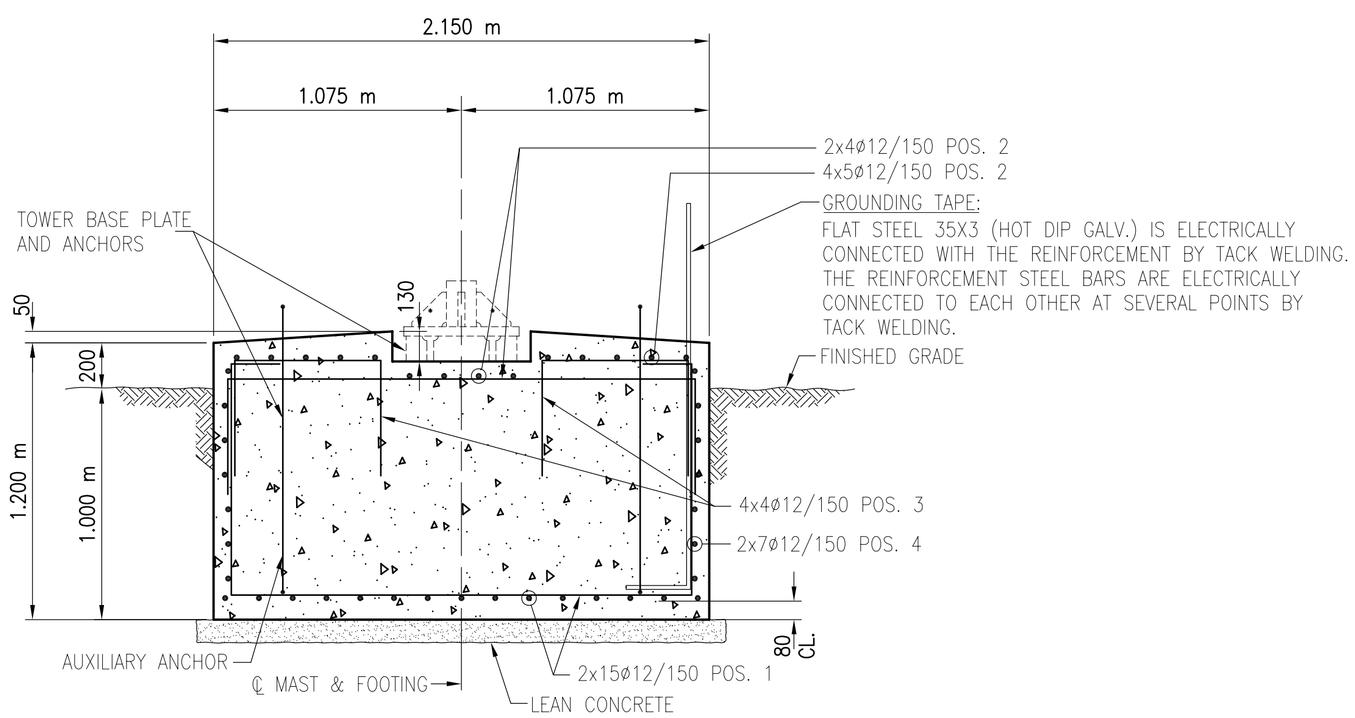

2 ST2 SECTION – TYPE A 1:20

NOTE:
ALL DIMENSIONS ARE IN MILLIMETERS UNLESS OTHERWISE NOTED.

CONCRETE COVER: 50mm ALL SURFACES EXCEPT BOTTOM OF FOOTINGS: 80mm.

EMBEDED ITEMS : 4 AUXILIARY ANCHORS.

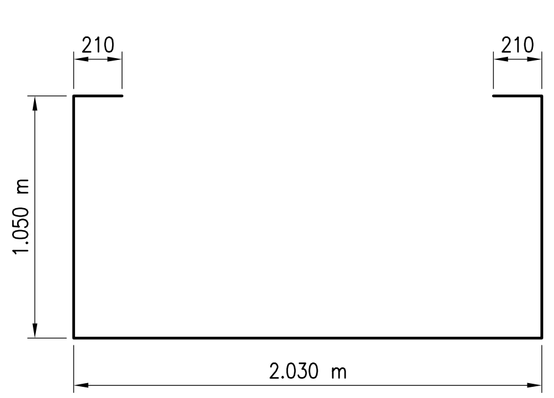

POS. 1
LG. = 4.550 m

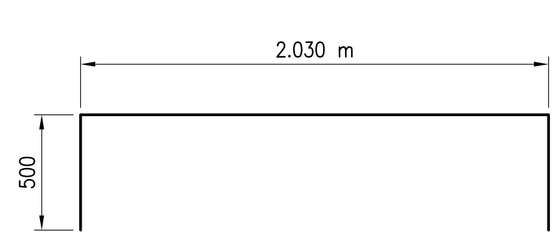

POS. 2
LG. = 3.030 m

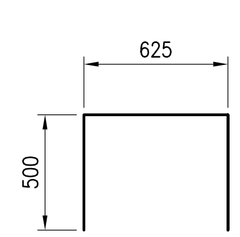

POS. 3
LG. = 1.625 m

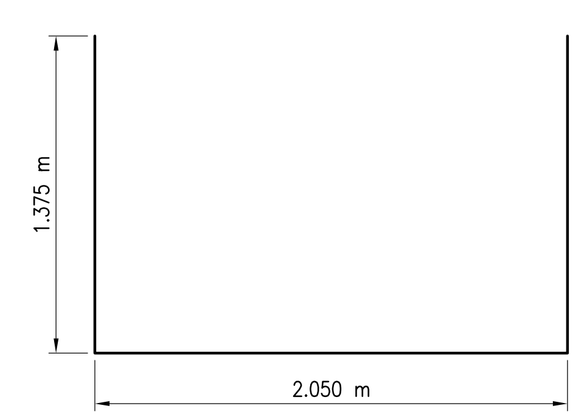

POS. 4
LG. = 4.800 m

AS BUILT

GRAPHIC SCALE:
0 0.25m 0.5m 1m
SCALE: 1:20 (METRIC)

SEAL:

REV	DESCRIPTIONS	DATE	APPD.

REVISION

INTERNATIONAL BROADCASTING BUREAU
ENGINEERING & TECHNICAL OPERATIONS
WASHINGTON, D.C. 20547

Bader Al Mulla & Bros. Co. W.L.L.
Engineering Group

		DATE
DRAWN	HAK	23/05/04
CHK. BY.	JPB	DATE
ENGR.	JPB	DATE

APPROVALS
PROJ. MANAGER TC

SHORTWAVE EXPANSION PROJECT
FOUNDATION TYPE A

KUWAIT

IQC No. XX-XX-XX
TASK No. X
PROJ. No. 03NC080
CAD DESIGN FILE NAME: FILENAME

DWG. No. BMB-AS-ST-02 ST2
SCALE: AS SHOWN SHEET 1 OF SHT

• 30 Galesi Drive, • Wayne, N.J. 07470 • TEL. : (973) 785-4545 • FAX : (973) 785-0766 • www.hansonengineers.com
HANSON
THALES BROADCAST & MULTIMEDIA
675 North Washington St., • Alexandria, VA. 22314 • TEL. : (703) 838-5544 • FAX : (703) 838-3264 • www.thales-bm.com •