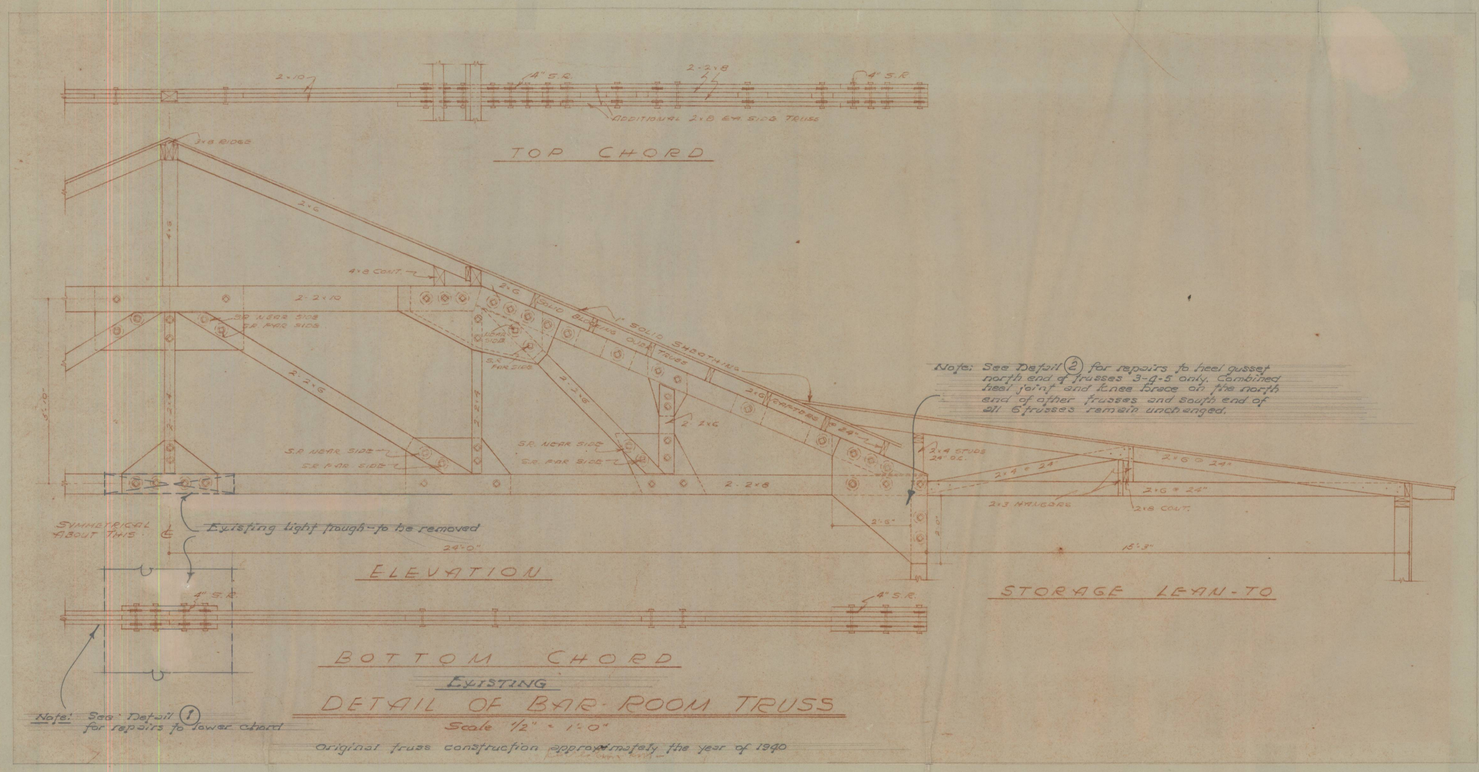

EXISTING
DETAIL OF BAR-ROOM TRUSS
Scale 1/2" = 1'-0"
Original truss construction approximately the year of 1940

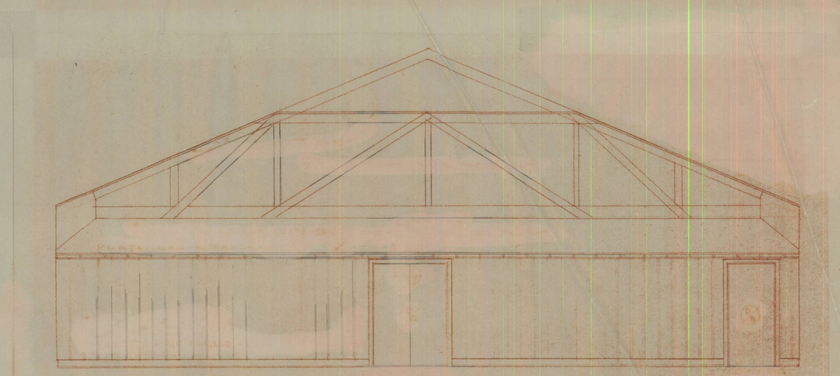

EXISTING
WEST ELEVATION
Scale: 1/4" = 1'-0"

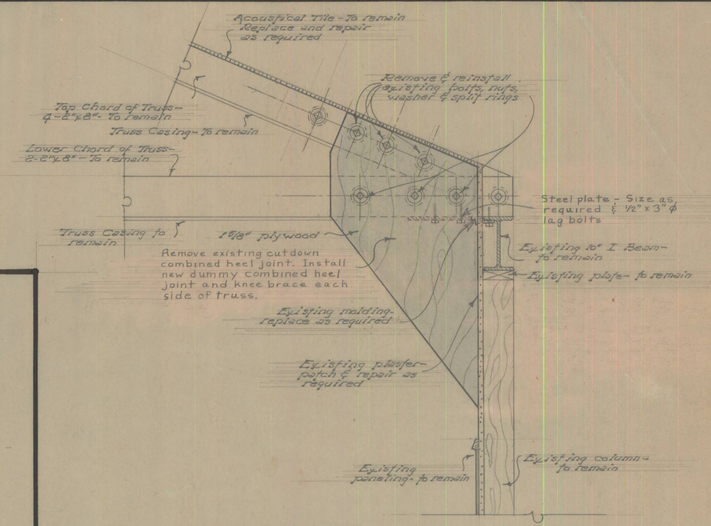

DETAIL 2
Scale: 1" = 1'-0"

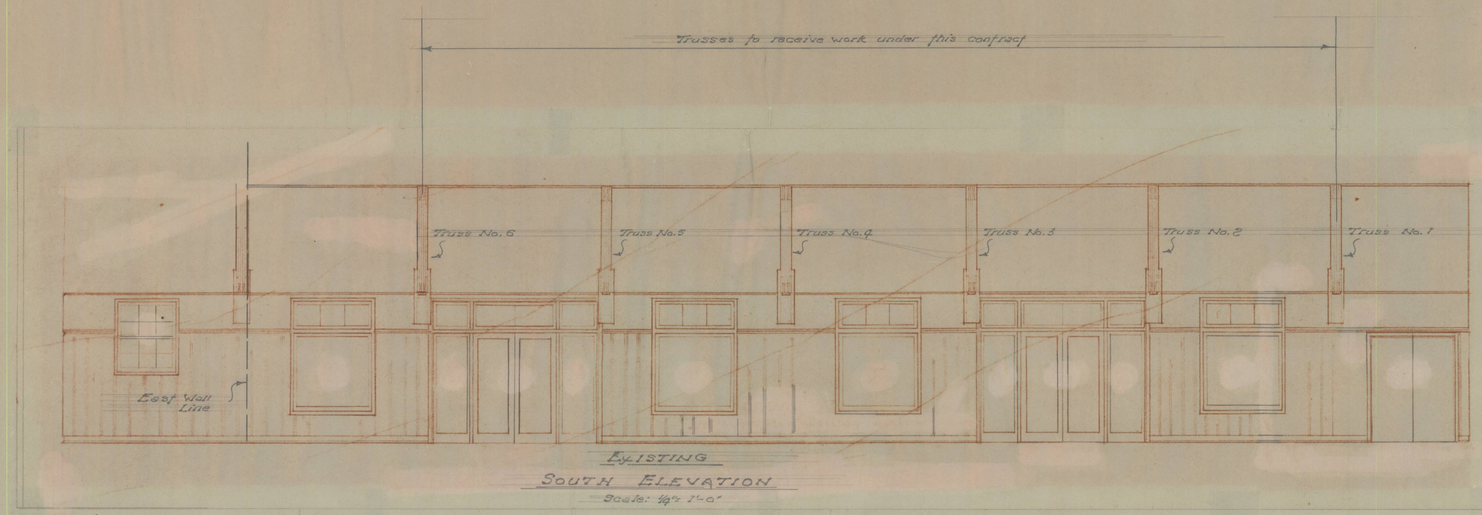

EXISTING
SOUTH ELEVATION
Scale: 1/4" = 1'-0"

Note: Existing installed wet-pipe fire sprinkler system is to remain in place and in operation at all times.

EXISTING TRUSS DEFLECTION	
Truss No.	Sag or Negative Camber of Lower Chord
1	1"
2	1 3/4"
3	1 3/4"
4	2 7/8"
5	3 1/8"
6	2 3/8"

Note:
1. Contractor shall field adapt to meet actual conditions
2. Wall and ceiling lining shall be removed and replaced as required.
3. All new bolts to be 3/4" ϕ MB with hex heads & nuts
4. All new washers shall be Open type - 2 per bolt
5. All trusses shall be stenciled on North end to read - "Truss Inspected (Month/year) And Bolts Tightened"

RECORD DRAWING - AS CONSTRUCTED
24 Dec '68 JTB

REVISION	DATE	DESCRIPTION	BY
1	25 Oct 68	Revised Brace Detail	LIR

OFFICE OF THE POST ENGINEER
FORT MACARTHUR, CALIFORNIA

DRAWN BY: LHJ
CHECKED BY: LJ
SUBMITTED BY:
PROJECT & PLANS

TRUSS REPAIR - BUILDING 403
LOWER RESERVATION
FORT MACARTHUR, CALIFORNIA

EXISTING TRUSS DETAILS, ELEVATIONS & SECTIONS

APPROVAL RECOMMENDED: PROJECT LEADER
APPROVED: CHIEF, ENGINEERING DIVISION

PREPARED UNDER THE DIRECTION OF
S. J. BLACK, LT. COL. C.E.
POST ENGINEER

DRAWING NO. 68-69
SHEET 3 OF 4

SCALE: As Noted
DATE: 28 Mar '68
P. R. NO. 1078

P.E. FILE NO. 7906