1. ALL DISTANCES DESIGNATED HERE ON ARE GRID DISTANCES.

2. ALL DISTANCES IN ELEVATIONS ARE IN METERS UNLESS OTHERWISE NOTED.

3. COORDINATE VALUES ARE BASED ON LOCAL DATUM.

4. VERTICAL DATUM IS BASED UPON THE ELEVATION OF THE EXISTING BUILDING FINISH FLOOR WITH AN ASSUMED ELEVATION OF 10.00 METERS.

5. ANTENNA AZIMUTH POINTING IS BASED UPON THE CLOCKWISE ANGLE FROM TRUE NORTH.

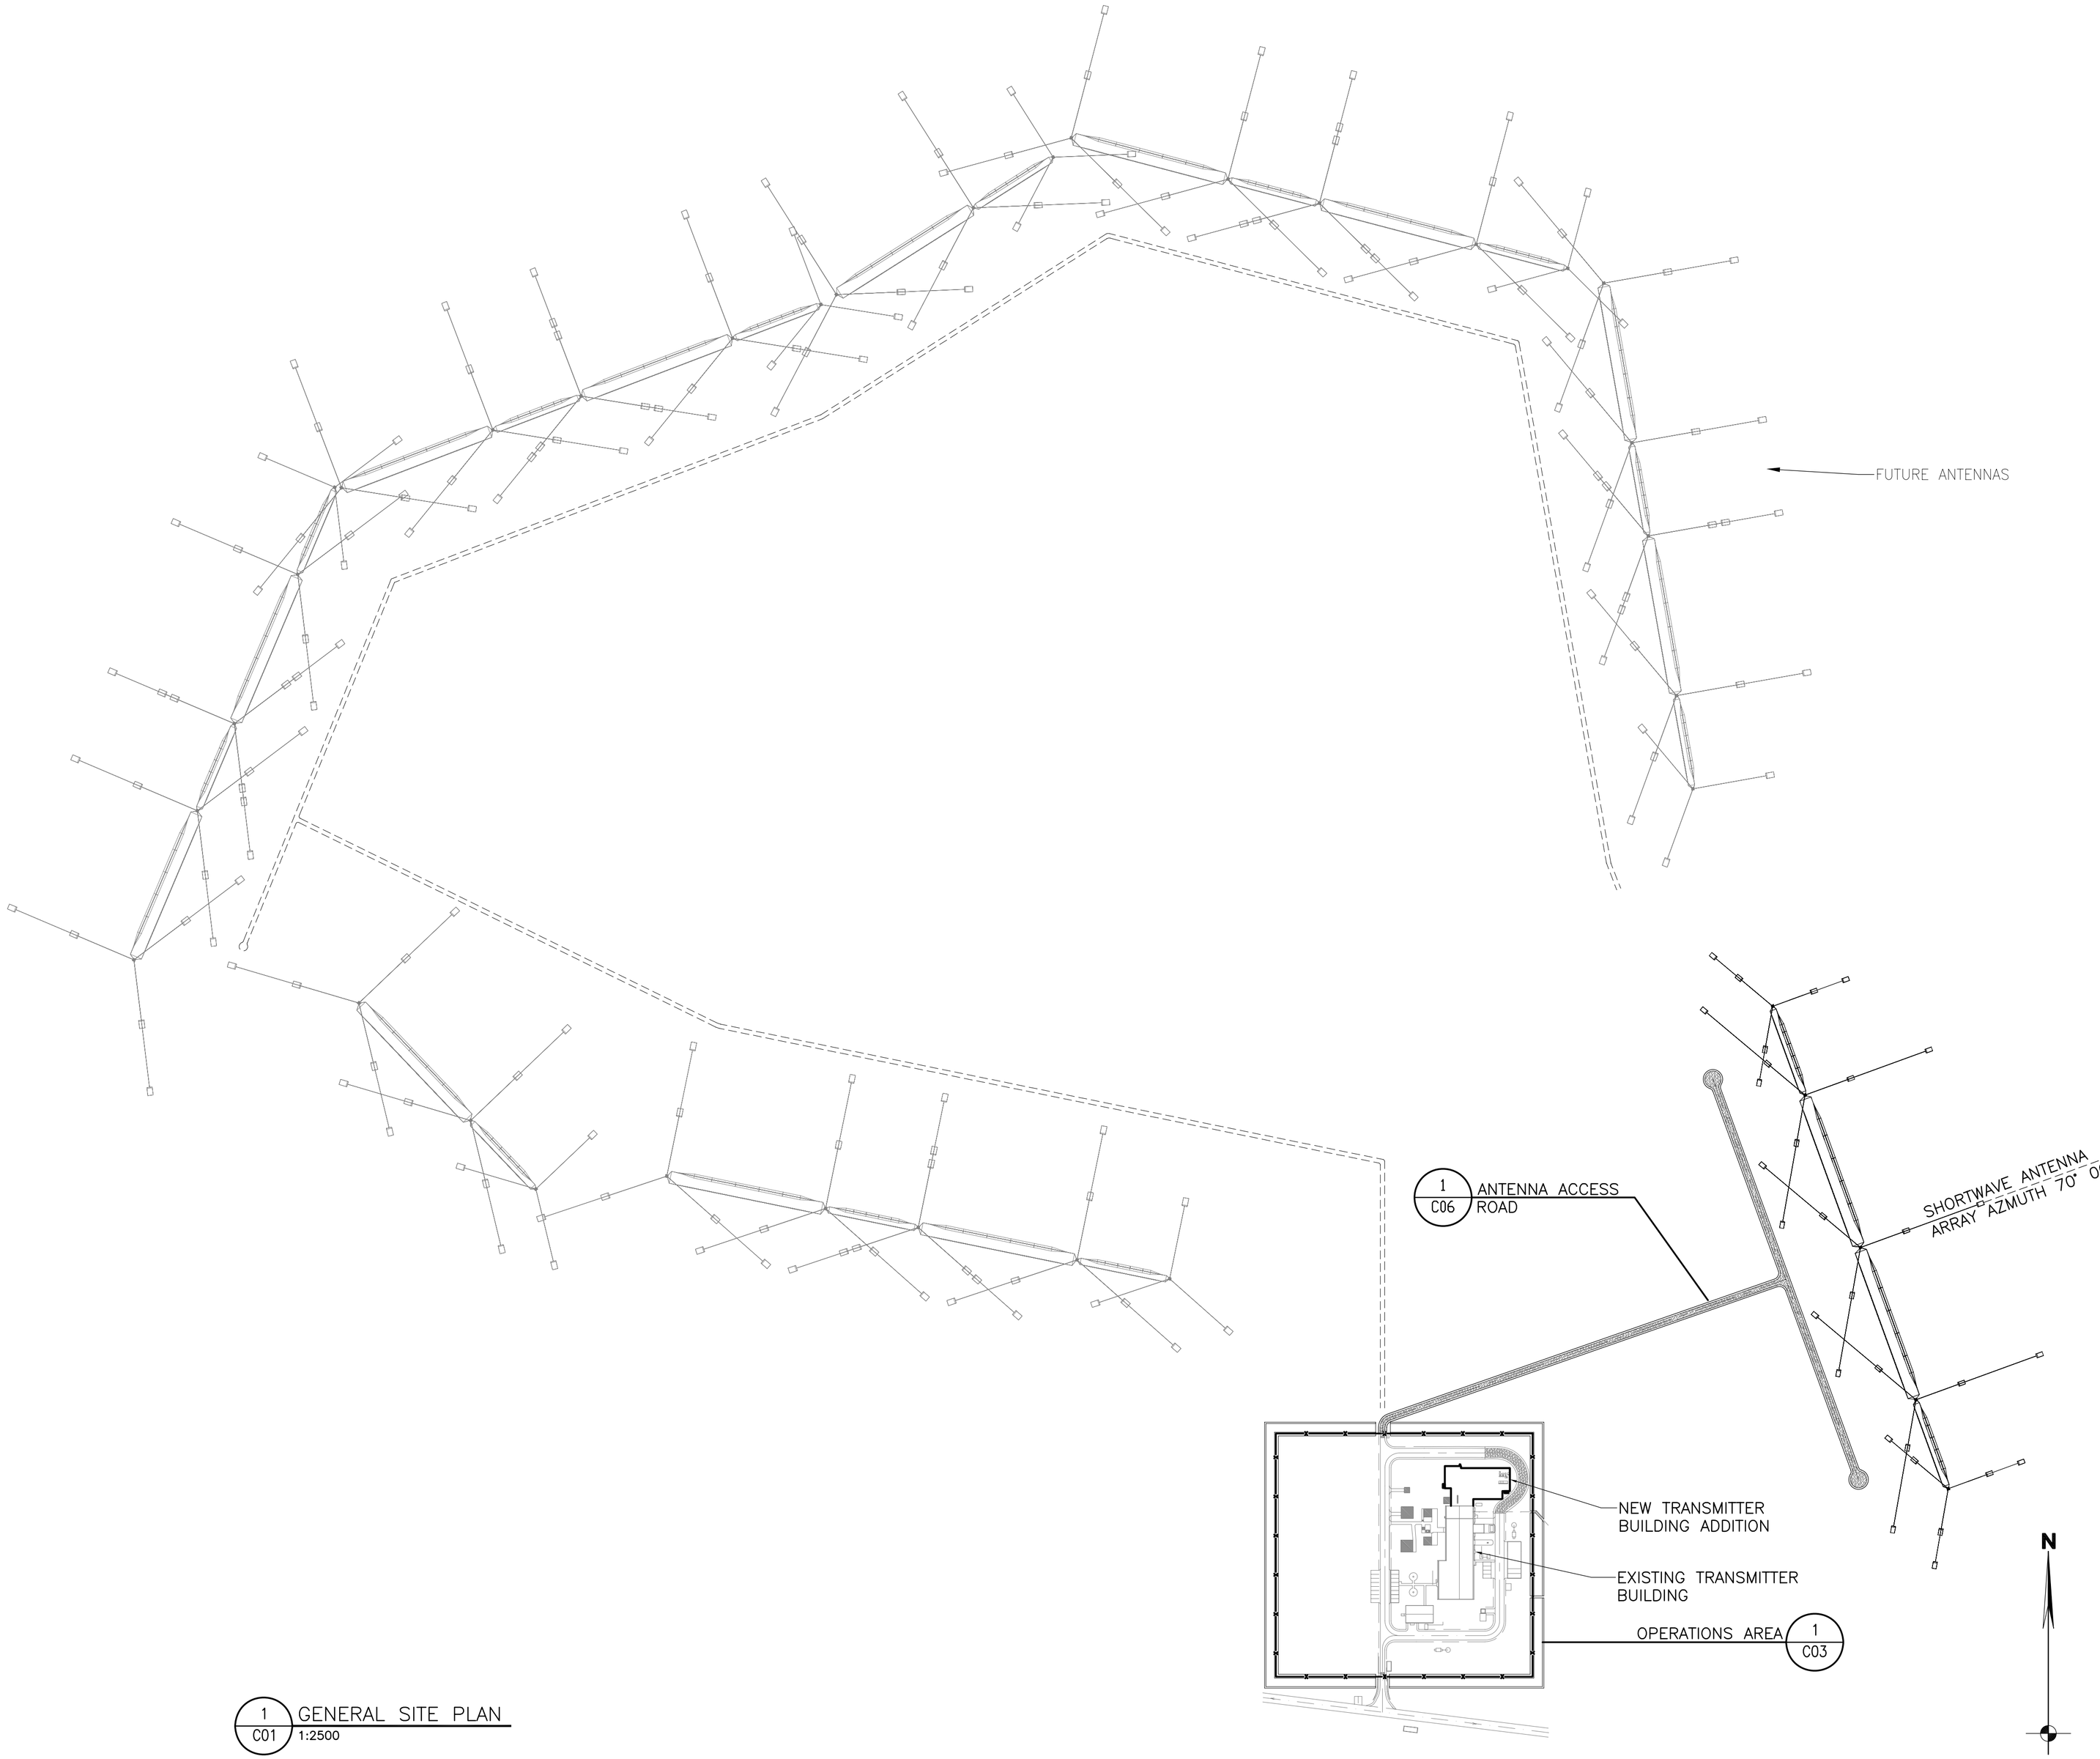

1 / C01 GENERAL SITE PLAN
1:2500

AS BUILT

GRAPHIC SCALE:
0 25m 50m 100m
SCALE: 1:2500(METRIC)

SEAL:

REV	DESCRIPTIONS	DATE	APPD.

REVISION

INTERNATIONAL BROADCASTING BUREAU
ENGINEERING & TECHNICAL OPERATIONS
WASHINGTON, D.C. 20547

Bader Al Mulla & Bros. Co. W.L.L.
Engineering Group

		DATE
DRAWN	HAK	23/05/04
CHK. BY.	JPB	DATE
ENGR.	JPB	DATE

APPROVALS
PROJ. MANAGER TC

SHORTWAVE EXPANSION PROJECT
GENERAL SITE PLAN
KUWAIT

IQC No. XX-XX-XX
TASK No. X
PROJ. No. 03NC080
CAD DESIGN FILE NAME: FILENAME

DWG. No. BMB-AS-C-01 — C01
SCALE: 1:2500 SHEET 1 OF SHT

• 30 Galesi Drive, Wayne, N.J. 07470 • TEL : (973) 785-4545 • FAX : (973) 785-0796 • www.hansonengineers.com
HANSON
THALES BROADCAST & MEDIA SYSTEMS
675 North Washington St., Alexandria, VA. 22314 • TEL : (703) 838-5844 • FAX : (703) 838-5854 • www.thales-bm.com