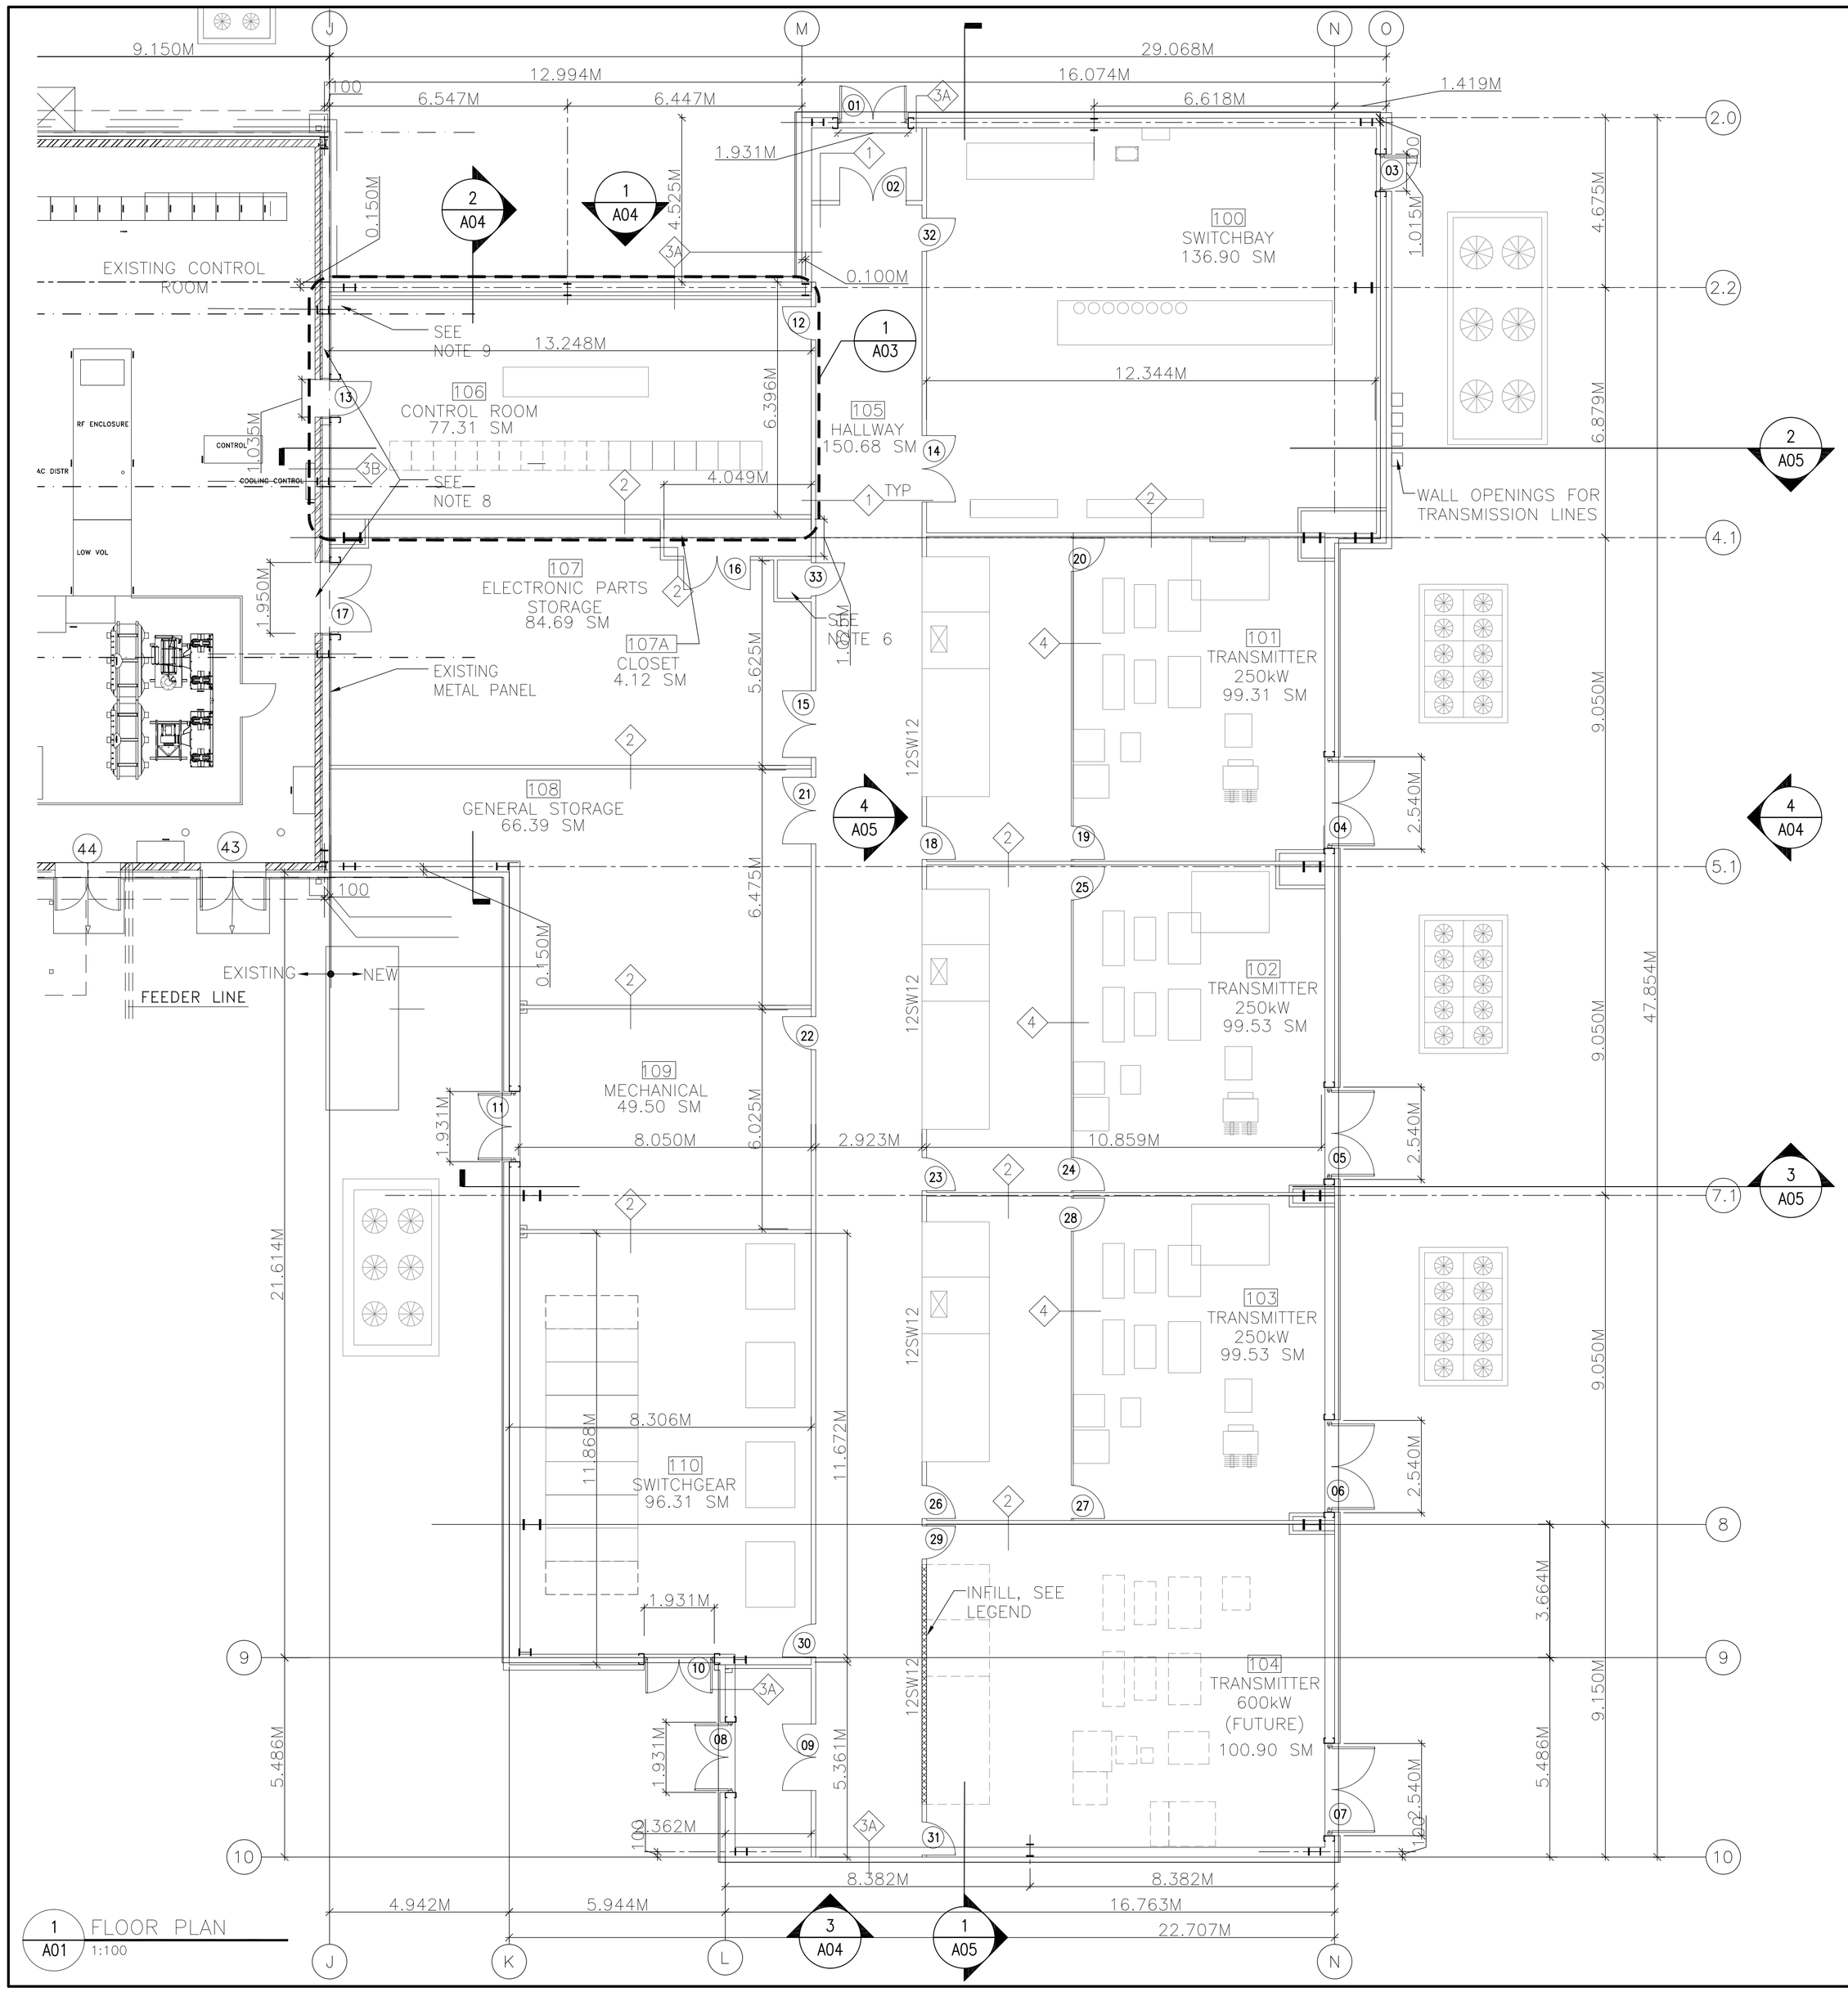

1 A01 FLOOR PLAN 1:100

LEGEND

- 2 A05 — SECTION OR ELEVATION TAG
- NEW GYPSUM BOARD PARTITION, REFER TO PARTITION TYPES ON A09
- NEW SCREEN WALLS, REFER TO PARTITION TYPES ON A09
- RATED INFILL GYPSUM BOARD PARTITION
- EXISTING WALLS TO BE DEMOLISHED & REMOVED
- 2 — REFER TO PARTITION TYPES ON A09
- 04 — DOOR NUMBERS, REFER TO DOOR SCHEDULES ON A08
- 100 ROOM — ROOM NAME AND NUMBER, REFER TO FINISH SCHEDULE
- NEW LINTEL OR HEADER, REFER TO A05 FOR DETAIL
- D — COLUMN LINE LABEL

AS BUILT

GRAPHIC SCALE:
0 1m 2m 5m
SCALE: 1:100 (METRIC)
0 4ft 8ft 16ft
SCALE: .12":1' (ENGLISH)
SCALE FACTOR – 100

SEAL:

REV	DESCRIPTIONS	DATE	APPD.

REVISION

		DATE
DRAWN	ED	07/11/03
CHK. BY.	ED	07/11/03
ENGR.	RF	07/11/03

INTERNATIONAL BROADCASTING BUREAU
ENGINEERING & TECHNICAL OPERATIONS
WASHINGTON, D.C. 20547

APPROVALS
PROJ. MANAGER TC

SHORTWAVE EXPANSION PROJECT
FLOOR PLAN
KUWAIT

IQC No.	XX-XX-XX	DWG. No. 2KW-TX-001	A01
TASK No.	X		
PROJ. No.	03NC080	SCALE: AS SHOWN	SHEET 21 OF 54
CAD DESIGN FILE NAME:	A-101A01.DWG		

• 30 Galesi Drive, • Wayne, N.J. 07470 • TEL: (973) 785-4545 • FAX: (973) 785-0766 • www.hansonengineers.com
HANSON
THALES BROADCAST & MULTIMEDIA
675 North Washington St., • Alexandria, VA. 22314 • TEL: (703) 836-5644 • FAX: (703) 836-2264 • www.thales-tm.com •