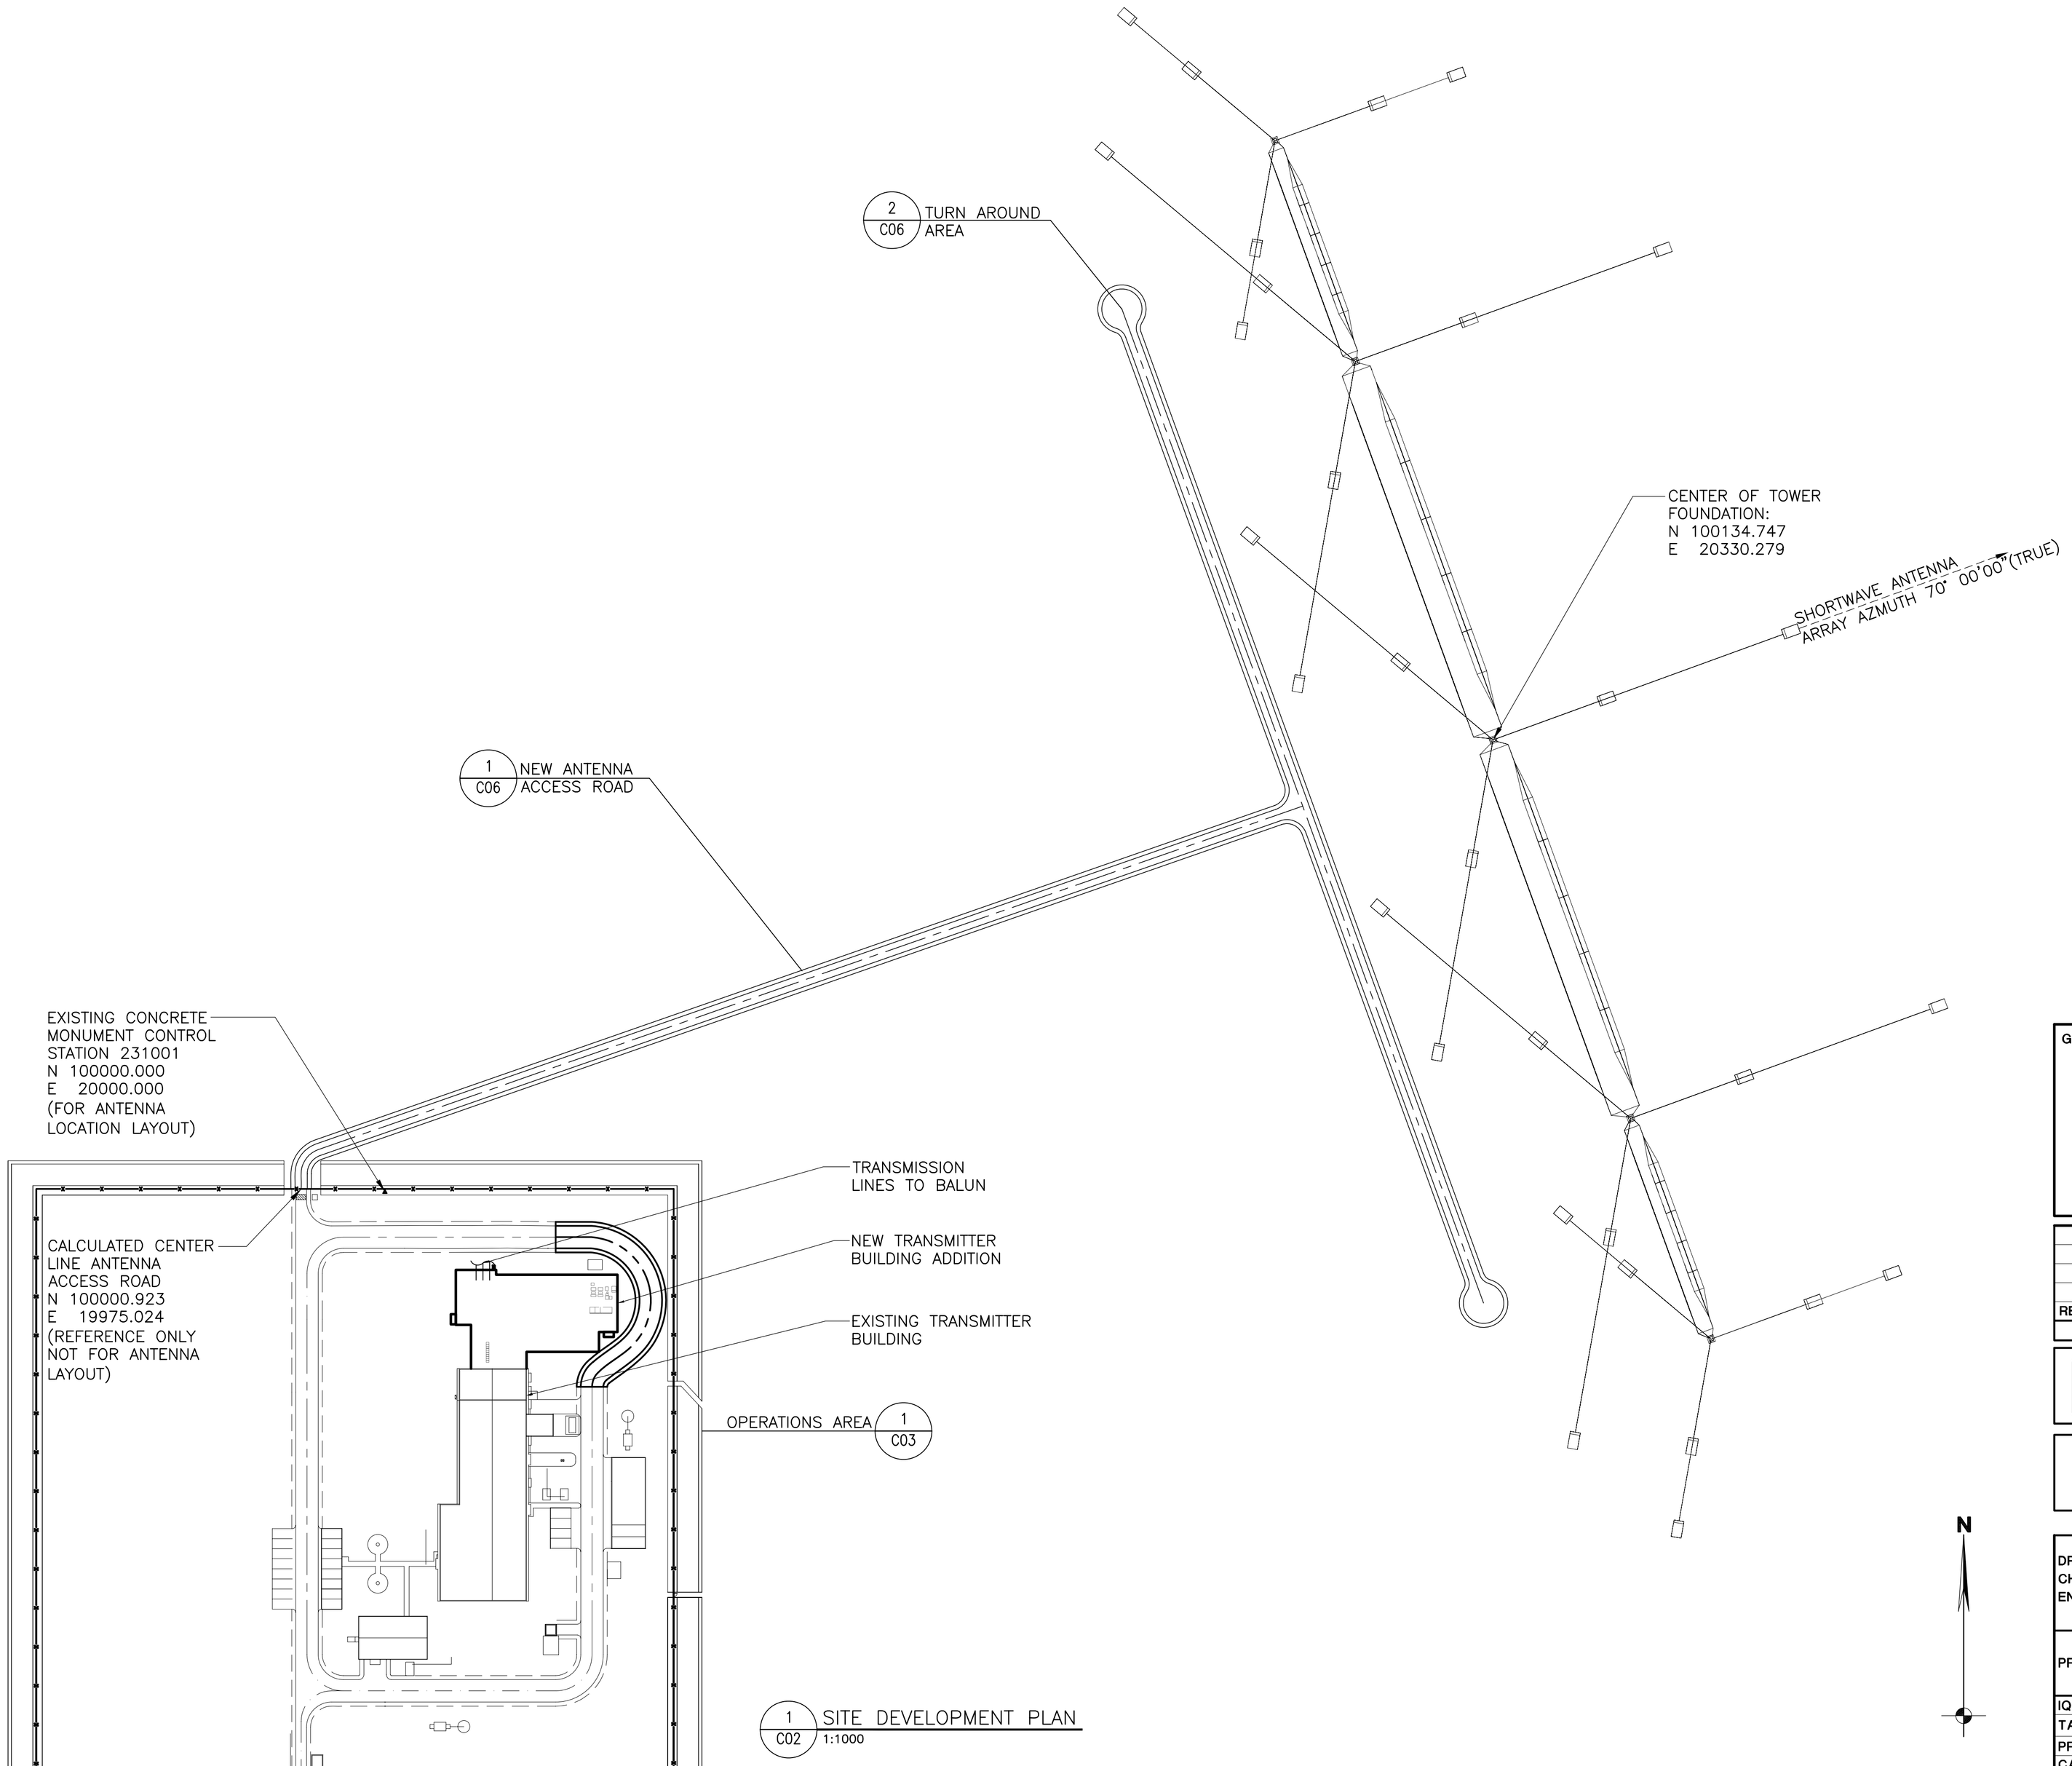

1 C02 SITE DEVELOPMENT PLAN
1:1000

AS BUILT

GRAPHIC SCALE:

0 10m 25m 50m

SCALE: 1:1000(METRIC)

SEAL:

REV	DESCRIPTIONS	DATE	APPD.

REVISION

INTERNATIONAL BROADCASTING BUREAU
ENGINEERING & TECHNICAL OPERATIONS
WASHINGTON, D.C. 20547

Bader Al Mulla & Bros. Co. W.L.L.
Engineering Group

		DATE
DRAWN	HAK	23/05/04
CHK. BY.	JPB	DATE
ENGR.	JPB	DATE

APPROVALS
PROJ. MANAGER TC

SHORTWAVE EXPANSION PROJECT
SITE DEVELOPMENT PLAN
KUWAIT

IQC No. XX-XX-XX
TASK No. X
PROJ. No. 03NC080
CAD DESIGN FILE NAME: FILENAME

DWG. No. BMB-AS-T-01 C02
SCALE: AS SHOWN SHEET 1 OF SHT

30 Gateal Drive, Wayne, N.J. 07470 TEL: (973) 785-4545 FAX: (973) 785-0766 www.hansonengineers.com
HANSON
THALES
675 North Washington St., Alexandria, VA. 22314 TEL: (703) 836-5644 FAX: (703) 836-3264 www.thales-bm.com