GENERAL NOTES

1. BUILDING SYSTEMS MANUFACTUTER TO DESIGN BUILDING FRAME FOR 1000 LBS MIN LATERAL LOAD AT ALL WALL BRACING COLUMNS PERPENDICULAR TO WALL.
2. PROVIDE VERTICALLY SLOTTED CONNECTIONS AT TOP OF EACH WALL BRACING COLUMN.
3. FOR WALL TYPE DETAILS SEE SECT 3/A-103

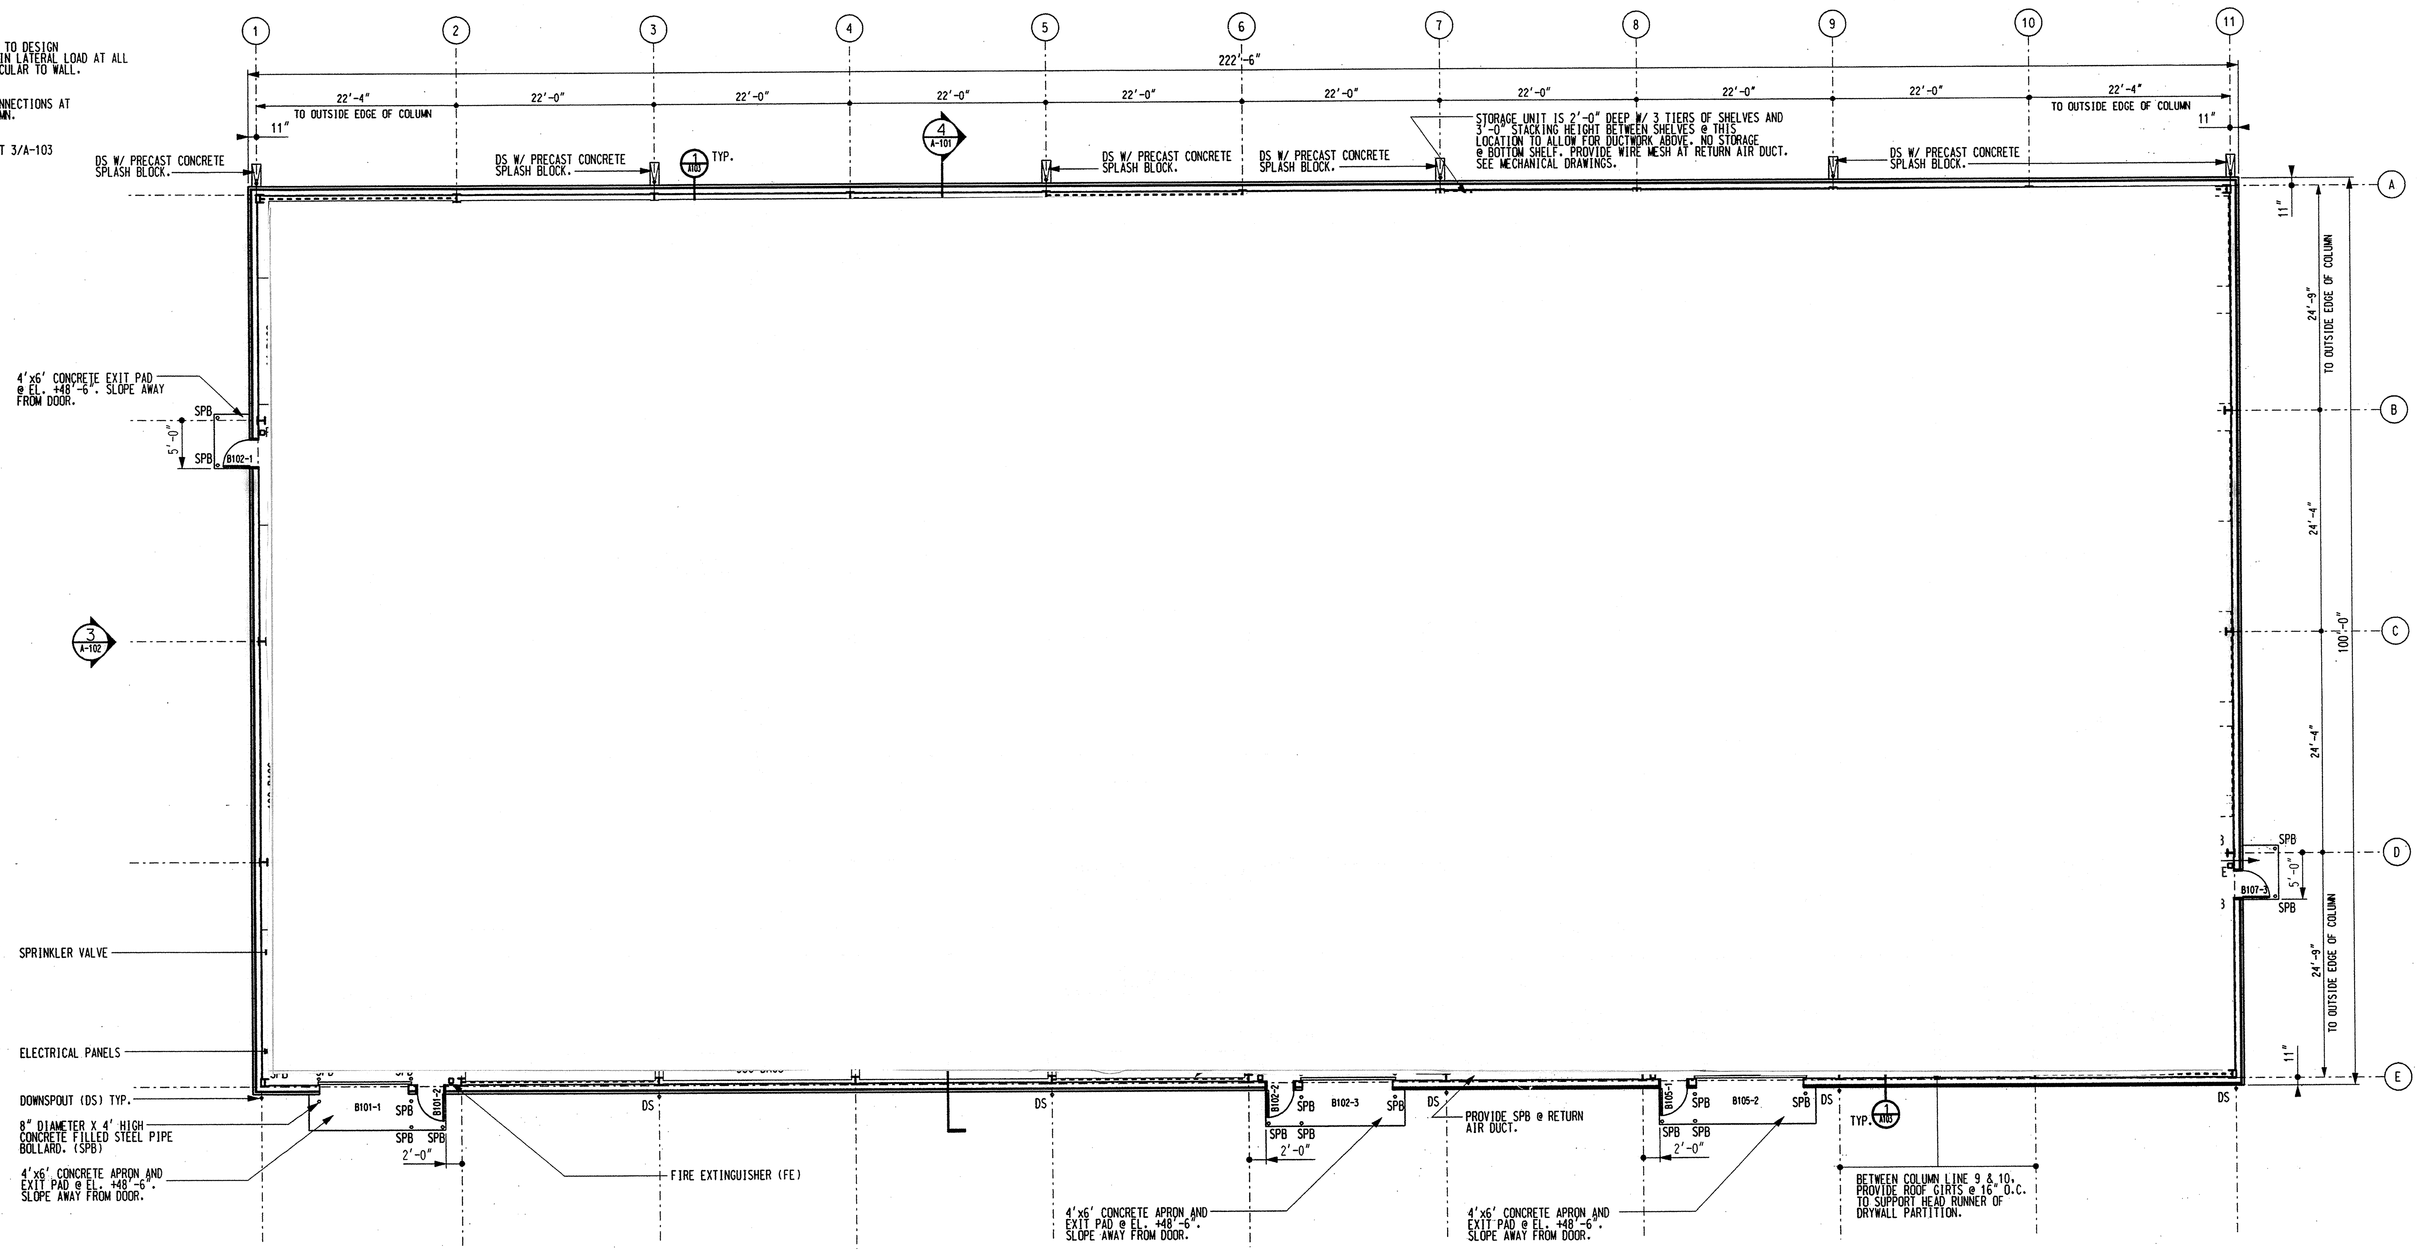

1 A-102 FIRST FLOOR PLAN
SCALE: 1/8" = 1'-0"
FINISH FLOOR: EL. +48'-6"

NOTE: PRE ENGINEERED BUILDING MANUFACTURE TO PROVIDE STRUCTURE FOR CONNECTION OF WALL BRACING COLUMNS.

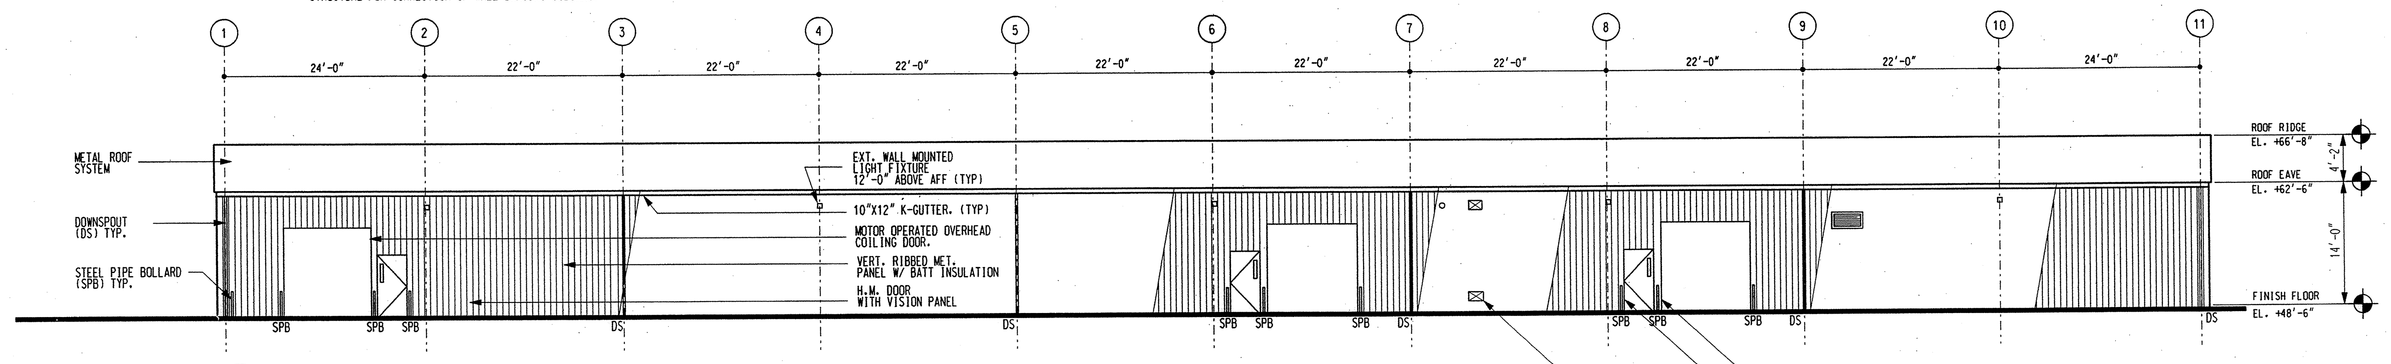

2 A-102 EAST ELEVATION
SCALE: 1/8" = 1'-0"

SEE MECHANICAL AND ELECTRICAL DRAWINGS FOR ALL ADDITIONAL AND REQUIRED EXTERIOR WALL OPENINGS. PROVIDE METAL ENCLOSURE ON ALL EDGES OF ALL RIBBED METAL PANELS AT ALL WALL PENITRATIONS. (TYP)

PROVIDE METAL ENCLOSURE ON EDGE OF ALL VERTICAL RIBBED METAL PANELS AT ALL WALL PENITRATIONS (TYP).

ROOM EQUIPMENT/AREA CHART	
ROOM NUMBER	NO. OF UNITS OR AREA PROVIDED
B102 BULK BAGGAGE	5584 BAGS @ 1' LINEAR PER BAG
B103 ELECTRONIC STORAGE	376' LINEAR STORAGE SPACE
B104 BULK BAGGAGE CONTAINER	66 CONTAINERS
B107 PROTOTYPE STORAGE	8 PROTOTYPES
B106 SUPPLY STORAGE	WALL SPACE FOR 16 (4'X2'X8'H) CABINETS
B105 CRATE STORAGE	54' X 13' AREA TO STORE/STAGE CRATED SHIPMENTS INBOUND AND OUTBOUND

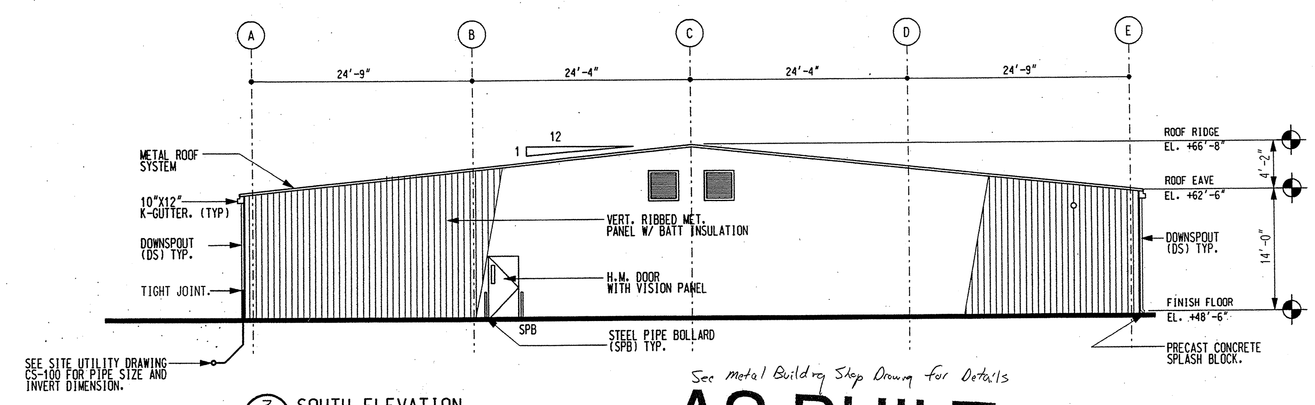

3 A-102 SOUTH ELEVATION
SCALE: 1/8" = 1'-0"

See Metal Building Shop Drawing for Details

AS BUILT

DATE 2-20-98

SEALS

REV	DATE	DESCRIPTION
	20 MAY 96	BID DOCUMENT

UNITED STATES DEPARTMENT OF TRANSPORTATION
FEDERAL AVIATION ADMINISTRATION TECHNICAL CENTER
ATLANTIC CITY INTERNATIONAL AIRPORT, NJ 08405
FAA LUGGAGE STORAGE BUILDINGS

APPROVED BY: MS. BASILYN BUNTING AAR 510

APPROVED BY: MR. FRANK SEMAN, MANAGER ACR 431

APPROVED BY: MR. DAVID DANDO: PROJECT MANAGER ACT 431

PROJECT ARCHITECT:
PROJECT ENGINEER:
The King-Lindquist Partnership Inc.
Architecture Engineering Planning
Interior Design & Consulting Services
1700 Market Street Suite 1600
Philadelphia, Pa 19103
215-569-2900

SCALE: AS NOTED
DRAWN BY: JRH
CK'D BY: JR
DATE: 11-10-95

DRAWING TITLE: BULK BUILDING FLOOR PLAN AND ELEVATIONS

DRAWING NUMBER: A-102

PROJECT NUMBER: 90-2853-08